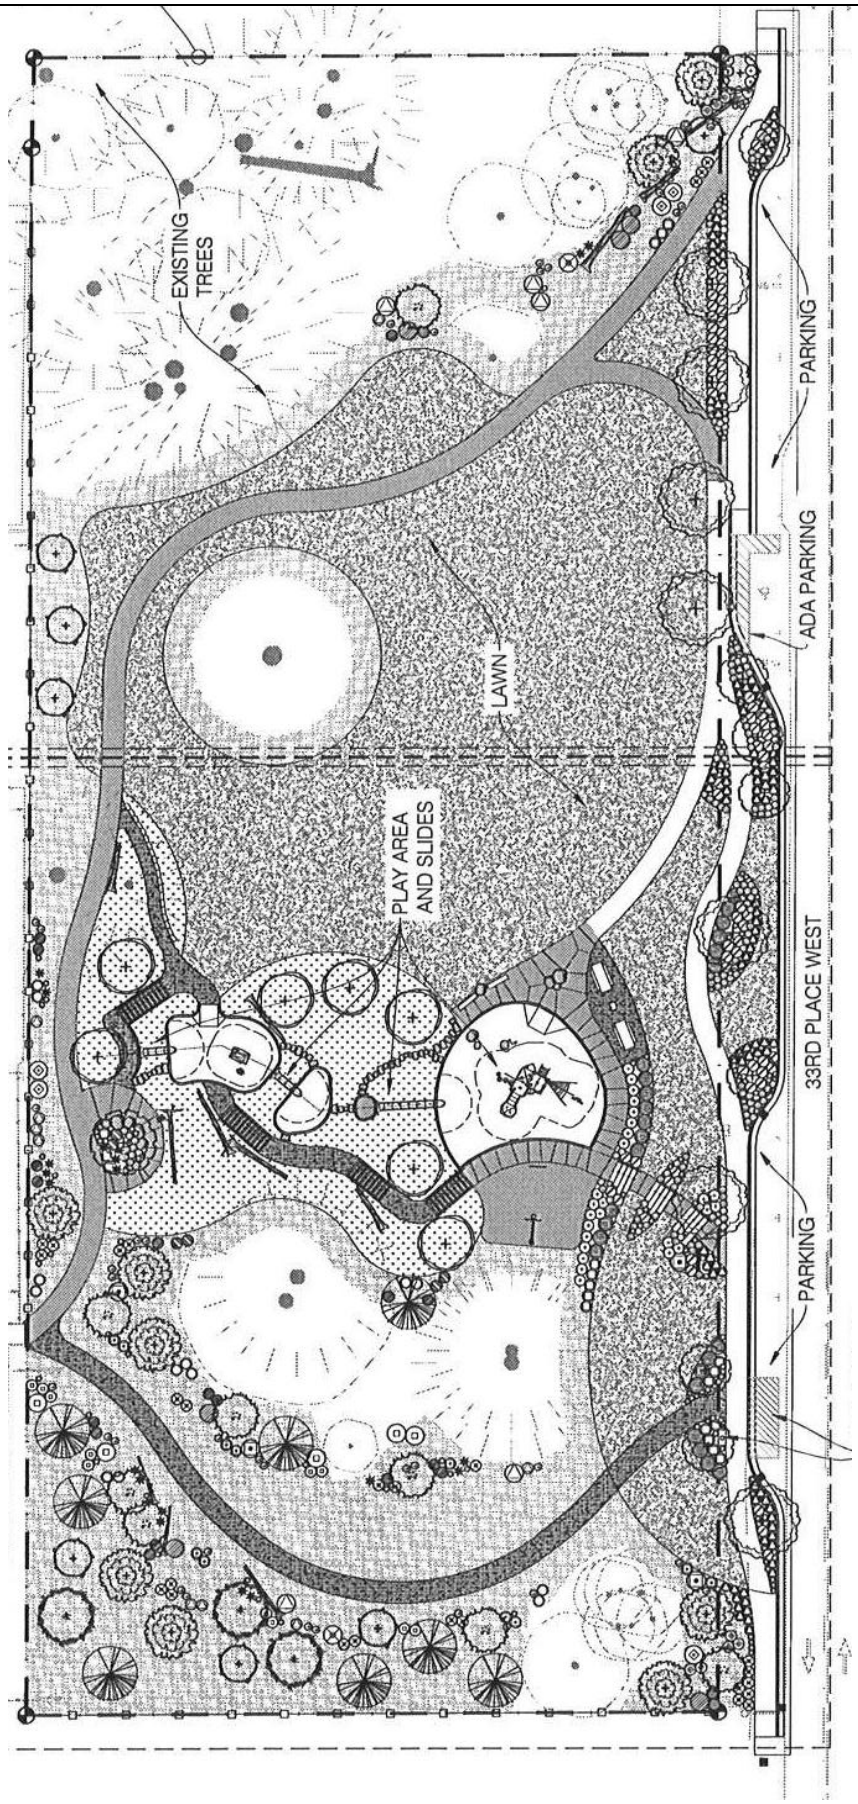

STADLER RIDGE PARK

17428 33rd Pl W